

44

Date: Friday, 10/5/2007 11:01:27 AM
 User: Kim Johnston

Process Sheet

Customer : CU-DAR001 Dart Helicopters Services	Drawing Name : 206L AFT X-TUBE
Job Number : 35042	
Estimate Number : 10973	
P.O. Number : <i>N/A</i>	Part Number : D206667203
This Issue : 10/5/2007 S.O. No. : <i>N/A</i>	Drawing Number : D206-667-243 REV B
Prsht Rev. : NC	Project Number : N/A
First Issue : <i>N/A</i> Type : LANDING GEAR	Drawing Revision : B
Previous Run : 35041	Material : <i>N/A</i>
Written By : <i>[Signature]</i>	Due Date : 10/30/2007 Qty: 1 Um: Each
Checked & Approved By : <i>[Signature]</i> 071005	
Comment : Est Rev: F 05.09.01 Add holes for compatibility with Bell Skid tubes KJ/JLM	

Additional Product

Job Number:



Seq. #:	Machine Or Operation:	Description :
---------	-----------------------	---------------

1.0	DC	DOCUMENT CONTROL
-----	----	------------------



Comment: DOCUMENT CONTROL

Photocopy bluefile and create labels as per PPP D206-667-203 CHG002

07/11/09

2.0	D6004115	Crosstube material
-----	----------	--------------------



Comment: Qty.: 1.0000 Each(s)/Unit Total : 1.0000 Each(s)

Pick:

Qty Part number Description Batch

1 D6004-115 Crosstube *B32305*

Check OD = 2.500"; ID = 1.800"

ml 07/10/18

3.0	MORI SEIKI	MORI SEIKI CNC LATHE LARGE
-----	------------	----------------------------



Comment: MORI SEIKI CNC LATHE LARGE

1-Fill tube with sand & install plugs DT8534 on both ends as per Folio FA089

2-Turn first side as per Folio FA089

3-Deburr & Inspect for surface damage. Repair damage within limits as per Dwg D206-667-243

07-10-20

(1)

4.0	QC1	INSPECT ALL DIM TO DIM SHEET
-----	-----	------------------------------



Comment: INSPECT ALL DIM TO DIM SHEET

07-10-20

(1)

W/O:		WORK ORDER CHANGES					
DATE	STEP	PROCEDURE CHANGE	By	Date	Qty	Approval Chief Eng / Prod Mgr	Approval QC Inspector

Part No: _____ PAR #: _____ Fault Category: _____ NCR: Yes No DQA: _____ Date: _____

QA: N/C Closed: _____ Date: _____

NCR:		WORK ORDER NON-CONFORMANCE (NCR)						
DATE	STEP	Description of NC Section A	Corrective Action Section B			Verification Section C	Approval Chief Eng	Approval QC Inspector
			Initial Chief Eng	Action Description Chief Eng	Sign & Date			

NOTE: Date & initial all entries

Date: Friday, 10/5/2007 11:01:28 AM
User: Kim Johnston

Process Sheet

Customer: CU-DAR001 Dart Helicopters Services

Drawing Name: 206L AFT X-TUBE

Job Number: 35042

Part Number: D206667203

Job Number:



Seq. #:

Machine Or Operation:

Description :

5.0

MORI SEIKI

MORI SEIKI CNC LATHE LARGE



Comment: MORI SEIKI CNC LATHE LARGE

1-Turn second side as per Folio FA089

2-Deburr & Inspect for surface damage. Repair damage within limits as per Dwg D206-667-243.

3-Remove sand and plugs

4-Scribe part # and batch # using vibrating stylus as per Dwg D206-667-243
Inside of Cuff(Donot engrave on outside of tube)

SG 07-10-20

(1)

6.0

QC1

INSPECT ALL DIM TO DIM SHEET



Comment: INSPECT ALL DIM TO DIM SHEET

SG 07-10-20

(1)

7.0

QC8

SECOND CHECK



Comment: SECOND CHECK

SG 07-10-21

(1)

8.0

LANDING GEAR 1

LANDING GEAR RESOURCE 1



Comment: LANDING GEAR RESOURCE 1

1-Polish entire outside surface of crosstube

SG 7-10-23

9.0

QC5

INSPECT WORK TO CURRENT STEP



Comment: INSPECT WORK TO CURRENT STEP

SG 07-10-23

10.0

HAND FINISHING1

HAND FINISHING RESOURCE #1



Comment: HAND FINISHING RESOURCE #1

Chemical Conversion Coat as per QSI 005 4.1

SG 7-10-23

11.0

BENDING

BENDING MACHINE



Comment: BENDING MACHINE

Bend tube as per Dwg D206-667-243 using CNC bender program 206L-AF and Folio FT

EL 7-10-26

W/O:		WORK ORDER CHANGES					
DATE	STEP	PROCEDURE CHANGE	By	Date	Qty	Approval Chief Eng / Prod Mgr	Approval QC Inspector

Part No: _____ PAR #: _____ Fault Category: _____ NCR: Yes No DQA: _____ Date: _____

QA: N/C Closed: _____ Date: _____

NCR:		WORK ORDER NON-CONFORMANCE (NCR)						
DATE	STEP	Description of NC Section A	Corrective Action Section B			Verification Section C	Approval Chief Eng	Approval QC Inspector
			Initial Chief Eng	Action Description Chief Eng	Sign & Date			

NOTE: Date & initial all entries

Date: Friday, 10/5/2007 11:01:28 AM
User: Kim Johnston

Process Sheet

Customer: CU-DAR001 Dart Helicopters Services

Drawing Name: 206L AFT X-TUBE

Job Number: 35042

Part Number: D206667203

Job Number:



Seq. #:

Machine Or Operation:

Description :

12.0

QC15

DIMENSIONAL CHECK OF X-TUBES



Comment: DIMENSIONAL CHECK OF X-TUBES

JA-10-26 ①

13.0

LANDING GEAR 1

LANDING GEAR RESOURCE 1



Comment: LANDING GEAR RESOURCE 1

1-Drill pilot holes in tube using drill Jig DT8583 & DT8584 as per Dwg D206-667-243. Drill all (3) top holes.

2-Drill and Ream all holes in tube to finish size using drill Jig DT8583 & DT8584 as per Dwg D206-667-243
Check dimensions between holes on all four sides.

3-Flip tube and switch drilling Jigs from right to left; left to right. Locate Jigs off existing holes using "T" pins.

4-Drill pilot holes using drill Jig DT8583 & DT8584 as per Dwg D206-667-243. Drill only the top (2) holes.

5-Drill & ream the top (2) holes to finish size using drill Jig DT8583 & DT8584 as per Dwg D206-667-243

6-Drill Fwd rivet holes using drill Jig DT8789FWD as per Dwg D206-667-143. Note: Fwd side has 3x top holes.

7-Drill Aft rivet holes using drill Jig DT8789 as per Dwg D206-667-243.

8-C'sink holes as per Dwg D206-667-243.

9-Deburr & Inspect for surface damage. Repair damage within limits as per Dwg D206-667-243

SR

7-10-28

- AWM 07-11-01

JD 7-10-30

14.0

HAND FINISHING1

HAND FINISHING RESOURCE #1



Comment: HAND FINISHING RESOURCE #1

Chemical Conversion Coat as per QSI 005 4.1

AWM 07-11-01

JD 7-10-30

15.0

QC3

INSPECT POWDER COAT/CHEMICAL CONVERSION



Comment: INSPECT POWDER COAT/CHEMICAL CONVERSION

AWM 07-11-01

16.0

QC5

INSPECT WORK TO CURRENT STEP



Comment: INSPECT WORK TO CURRENT STEP

checked holes

AWM 07-11-01

JD 7-10-30

Dart Aerospace Ltd

W/O:		WORK ORDER CHANGES					
DATE	STEP	PROCEDURE CHANGE	By	Date	Qty	Approval Chief Eng / Prod Mgr	Approval QC Inspector

Part No: _____ PAR #: _____ Fault Category: _____ NCR: Yes No DQA: _____ Date: _____

QA: N/C Closed: _____ Date: _____

NCR:		WORK ORDER NON-CONFORMANCE (NCR)						
DATE	STEP	Description of NC Section A	Corrective Action Section B			Verification Section C	Approval Chief Eng	Approval QC Inspector
			Initial Chief Eng	Action Description Chief Eng	Sign & Date			

NOTE: Date & initial all entries

Date: Friday, 10/5/2007 11:01:28 AM
User: Kim Johnston

Process Sheet

Customer: CU-DAR001 Dart Helicopters Services

Drawing Name: 206L AFT X-TUBE

Job Number: 35042

Part Number: D206667203

Job Number:



Seq. #:

Machine Or Operation:

Description :

17.0

OUTSIDE SERV.10

OUTSIDE SERVICES -LG



Comment: Sub-Contracting OUTSIDE SERVICES

Liquid Penetrant Inspection as per QSI 038Or

Issue P/O: 4973

LPI as per ASTM 1417

Level 2 Attach copy of NDT results to work order

C207/11/05 ①

18.0

PACKAGING 1

PACKAGING RESOURCE #1



Comment: PACKAGING RESOURCE #1

Inspect for transit damage

Ensure copy of NDT results attached to work order.

C207/11/05 ①

19.0

QC6

DIMENSIONAL CHECK



Comment: Inspect for damage & ensure results are as per Dwg D206-667-103

C207/11/05

20.0

SPRAY PAINTING

SPRAY PAINTING



Comment: SPRAY PAINTING

~~1-Mask Threaded holes.~~ N/A

2-Prime inside and outside crosstube as per QSI 005 4.2

3-Paint outside crosstube with White Imron as per QSI 005 4.2

ml 07 11 06 ①

21.0

QC14

INSPECT SPRAY PAINT



Comment: Inspect Spray Paint

Wrap in plastic bag to protect from scratches

C207/11/06

22.0

D2873045

Nut Plate Assembly



Comment: Qty.: 2.0000 Each(s)/Unit Total : 2.0000 Each(s)

Pick:

Qty Part number Description Batch

2 D2873-045

Nut Plate

33692

ml 07 11 06

W/O:		WORK ORDER CHANGES					
DATE	STEP	PROCEDURE CHANGE	By	Date	Qty	Approval Chief Eng / Prod Mgr	Approval QC Inspector

Part No: _____ PAR #: _____ Fault Category: _____ NCR: Yes No DQA: _____ Date: _____

QA: N/C Closed: _____ Date: _____

NCR:		WORK ORDER NON-CONFORMANCE (NCR)						
DATE	STEP	Description of NC Section A	Corrective Action Section B			Verification Section C	Approval Chief Eng	Approval QC Inspector
			Initial Chief Eng	Action Description Chief Eng	Sign & Date			

NOTE: Date & initial all entries

Date: Friday, 10/5/2007 11:01:28 AM
User: Kim Johnston

Process Sheet

Customer: CU-DAR001 Dart Helicopters Services

Drawing Name: 206L AFT X-TUBE

Job Number: 35042

Part Number: D206667203

Job Number:



Seq. #:

Machine Or Operation:

Description :

23.0

D2873043

Nut Plate Assembly



Comment: Qty.: 2.0000 Each(s)/Unit Total : 2.0000 Each(s)

Pick:

Qty Part number Description Batch

2 D2873-043

Nut Plate

33422

ml 07 11 06

24.0

MS20601AD4W10

RIVET



Comment: Qty.: 14.0000 Each(s)/Unit Total : 14.0000 Each(s)

Pick:

Qty Part number Description Batch

14 MS20601AD4W10 Rivet

105057

ml 07 11 06

25.0

LANDING GEAR 1

LANDING GEAR RESOURCE 1



Comment: LANDING GEAR RESOURCE 1

1-Install nut plates as per Dwg D206-667-243.

ml 07 11 06

26.0

D2856400

Abrasion Strip



Comment: Qty.: 1.3525 f(s)/Unit Total : 1.3525 f(s)

Pick:

Qty Part number Description Batch

2 D2856-400(Cut to 7.73") Abrasion Strip

34642

ml 07 11 07

27.0

D28921

Support



Comment: Qty.: 2.0000 Each(s)/Unit Total : 2.0000 Each(s)

Pick:

Qty Part number Description Batch

2 D2892-1

Support

28389

ml 07 11 07

28.0

MS2192022

Clamp(per MIL-DTL-8783C)



Comment: Qty.: 4.0000 Each(s)/Unit Total : 4.0000 Each(s)

Pick:

Qty Part number Description Batch

4 MS21920-22

Clamp

105799

ml 07 11 07

Dart Aerospace Ltd

W/O:		WORK ORDER CHANGES					
DATE	STEP	PROCEDURE CHANGE	By	Date	Qty	Approval Chief Eng / Prod Mgr	Approval QC Inspector

Part No: _____ PAR #: _____ Fault Category: _____ NCR: Yes No DQA: _____ Date: _____

QA: N/C Closed: _____ Date: _____

NCR:		WORK ORDER NON-CONFORMANCE (NCR)						
DATE	STEP	Description of NC Section A	Corrective Action Section B			Verification Section C	Approval Chief Eng	Approval QC Inspector
			Initial Chief Eng	Action Description Chief Eng	Sign & Date			

NOTE: Date & initial all entries

Date: Friday, 10/5/2007 11:01:28 AM
User: Kim Johnston

Process Sheet

Customer: CU-DAR001 Dart Helicopters Services

Drawing Name: 206L AFT X-TUBE

Job Number: 35042

Part Number: D206667203

Job Number:



Seq. #:

Machine Or Operation:

Description :

29.0

LANDING GEAR 1

LANDING GEAR RESOURCE 1



Comment: LANDING GEAR RESOURCE 1

1-Install abrasion strips as per QSI 035 using DT8580. .Note: (3) top holes should be facing up.

2-Install supports and clamps as per Dwg D206-667-243. Torque clamps to 80-100 in lb

m
071107

30.0

QC5

INSPECT WORK TO CURRENT STEP



Comment: INSPECT WORK TO CURRENT STEP

6/21/08

31.0

PACKAGING 1

PACKAGING RESOURCE #1



Comment: PACKAGING RESOURCE #1

• Pick Packing Kit

32.0

AN534A

Bolt



Comment: Qty.: 4.0000 Each(s)/Unit Total : 4.0000 Each(s)

Bolt

Batch: *M105408*

CU

33.0

MS21042L5

Nut



Comment: Qty.: 4.0000 Each(s)/Unit Total : 4.0000 Each(s)

Nut

Batch: *M105430*

CU

34.0

AN510A

Bolt



Comment: Qty.: 10.0000 Each(s)/Unit Total : 10.0000 Each(s)

Pick:Packing Kit

Qty Part number

Description Batch

10 AN5-10A

Bolt

M104156

CU

35.0

AN532A

Bolt



Comment: Qty.: 4.0000 Each(s)/Unit Total : 4.0000 Each(s)

Pick:Packing Kit

Qty Part number

Description Batch

M104679

CU 7/11/08

Dart Aerospace Ltd

W/O:		WORK ORDER CHANGES					
DATE	STEP	PROCEDURE CHANGE	By	Date	Qty	Approval Chief Eng / Prod Mgr	Approval QC Inspector

Part No: _____ PAR #: _____ Fault Category: _____ NCR: Yes ☒ No ☐ DQA: D Date: 8/11/09
 QA: N/C Closed: _____ Date: _____

NCR:		WORK ORDER NON-CONFORMANCE (NCR)						
DATE	STEP	Description of NC Section A	Corrective Action Section B			Verification Section C	Approval Chief Eng	Approval QC Inspector
			Initial Chief Eng	Action Description Chief Eng	Sign & Date			

NOTE: Date & initial all entries

Date: Friday, 10/5/2007 11:01:28 AM
User: Kim Johnston

Process Sheet

Customer: CU-DAR001 Dart Helicopters Services

Drawing Name: 206L AFT X-TUBE

Job Number: 35042

Part Number: D206667203

Job Number:



Seq. #:

Machine Or Operation:

Description :

4 AN5-32A

Bolt

36.0

AN960JD516

Washer



Comment: Qty.: 18.0000 Each(s)/Unit Total : 18.0000 Each(s)

Pick: Packing Kit

Qty Part number

Description Batch

18 AN960JD516

Washer

M104156

10/11/08 (1)

37.0

QC4

INSPECT 100% KITS FOR COMPLETENESS



Comment: INSPECT 100% KITS FOR COMPLETENESS

2 7/11/09

38.0

PACKAGING 1

PACKAGING RESOURCE #1



Comment: PACKAGING RESOURCE #1

Identify and pack for shipping as per PPP D206-667-203

Location:

PPP Rev:

C

7-11-09

SD-1X (Signature)

39.0

QC21

FINAL INSPECTION/W/O RELEASE



Comment: FINAL INSPECTION/W/O RELEASE

2 7/11/09 (Signature)

Job Completion



12 5/11/09

Dart Aerospace Ltd

W/O:		WORK ORDER CHANGES					
DATE	STEP	PROCEDURE CHANGE	By	Date	Qty	Approval Chief Eng / Prod Mgr	Approval QC Inspector

Part No: _____ PAR #: _____ Fault Category: _____ NCR: Yes No DQA: _____ Date: _____

QA: N/C Closed: _____ Date: _____

NCR:		WORK ORDER NON-CONFORMANCE (NCR)						
DATE	STEP	Description of NC Section A	Corrective Action Section B			Verification Section C	Approval Chief Eng	Approval QC Inspector
			Initial Chief Eng	Action Description Chief Eng	Sign & Date			

NOTE: Date & initial all entries

DART AEROSPACE LTD	Work Order:	35042
Description: Crosstube Assembly	Part Number:	D206-667-243
Inspection Dwg: D206-667-243 Rev: B		Page 1 of 1

FIRST ARTICLE INSPECTION CHECKLIST

☒ First Article ☐ Prototype


Inspection Sheet Drawing Dimension	Tolerance	Actual Dimension	Accept	Reject	Method of Inspection	Comments
SIDE A	2.490	+0.005/-0.000	2.494	✓		
	2.018	+0.005/-0.000	2.022	✓		
	2.079	+0.005/-0.000	2.083	✓		
	2.145	+0.005/-0.000	2.149	✓		
	2.209	+0.005/-0.000	2.213	✓		
	2.287	+0.005/-0.000	2.287	✓		
	2.363	+0.005/-0.000	2.367	✓		
	2.433	+0.005/-0.000	2.437	✓		
	0.200	+/-0.010	.200	✓		
	0.500 x 30°	+/-0.010	.500	✓		
	R0.063	+/-0.010	.063	✓		
	R0.500	+/-0.010	.500	✓		
	4.438	+/-0.030	4.438	✓		
SIDE B	104.91	+/-0.020	104.91	✓		
	2.490	+0.005/-0.000	2.494	✓		
	2.018	+0.005/-0.000	2.022	✓		
	2.079	+0.005/-0.000	2.083	✓		
	2.145	+0.005/-0.000	2.149	✓		
	2.209	+0.005/-0.000	2.213	✓		
	2.287	+0.005/-0.000	2.291	✓		
	2.363	+0.005/-0.000	2.367	✓		
	2.433	+0.005/-0.000	2.437	✓		
	0.200	+/-0.010	.200	✓		
	0.500 x 30°	+/-0.010	.500	✓		
	R0.063	+/-0.010	.063	✓		
	R0.500	+/-0.010	.500	✓		
	4.438	+/-0.030	4.438	✓		

Measured by:	<i>EC</i>	Audited by:	<i>ML</i>	Prototype Approval:	N/A
Date:	07.10.20	Date:	07/10/21	Date:	N/A

Rev	Date	Change	Revised by	Approved
A	06.09.01	New Issue (P/O D206-667-203)	KJ/JLM	<i>JS</i>

DART AEROSPACE LTD		Work Order:	35042
Description: Crosstube High Aft (206L)		Part Number:	D206-667-203
Inspection Dwg: D206-667-243 Rev: B		Page 1 of 1	

Required Dimension	Min	Max
Height	23.46	23.58
1/2 Span	41.86	41.98
Angle	54	56
Total Span	83.72	83.96

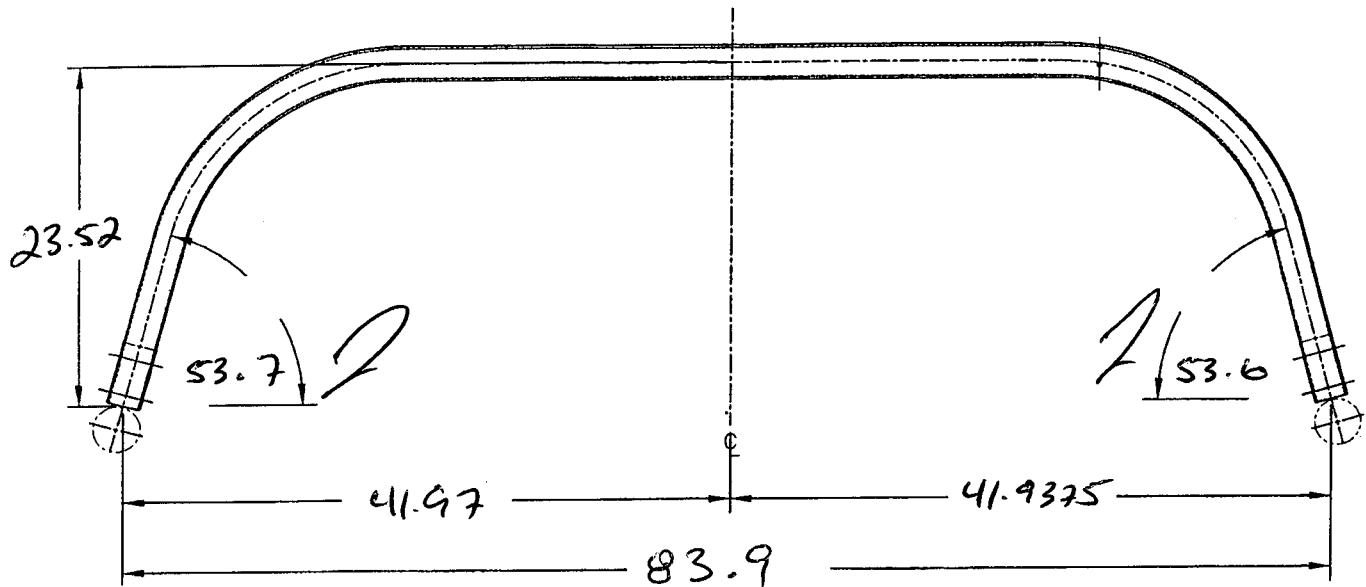

Comments

QC15 Inspection	<i>[Signature]</i>
Date	

Rev	Date	Change	Revised by	Approved
A	07.02.06	New Issue	KJ/JM <i>[Signature]</i>	<i>[Signature]</i>



DESIGN PH	DRAWN BY PH	DART AEROSPACE LTD HAWKESBURY, ONTARIO, CANADA	
CHECKED # DS	APPROVED # DS	DRAWING NO. D206-667-243	REV. B SHEET 1 OF 3
DATE 05.07.26		TITLE CROSSTUBE ASS'Y (206L HIGH AFT) NTS	
A	00.11.17	NEW ISSUE	
B	05.07.26	ADD HOLES AND NUT PLATES FOR COMPATABILITY WITH BHT/AA SKIDTUBES	

RELEASED
05-07-26 #

UNDER REVIEW

06.07.10 RH

12 draw detail F

RH
07.05.02

Qty	Part Number	Description
X	D206-667-243	CROSSTUBE ASSEMBLY
1	D6004-115	CROSSTUBE
2	D2856-400-773	ABRASION STRIP
2	D2873-043	NUT PLATE
2	D2873-045	NUT PLATE
2	D2892-1	SUPPORT
14	MS20601AD4W10	RIVET (OR NAS9302B-4-10)
4	MS21920-22	CLAMP



GENERAL NOTES:

- 1) TOLERANCES ARE PER DART QSI 018 UNLESS OTHERWISE NOTED.
- 2) MATERIAL: MANUFACTURED FROM D6004-115
FINISHED LENGTH = 104.91±0.020
- 3) FINISH: CHEMICAL CONVERSION COAT PER DART QSI 005 4.1
PRIME INSIDE AND OUTSIDE PER DART QSI 005 4.2
PAINT OUTSIDE PER DART QSI 005 4.2
- 4) PART IS SYMMETRIC ABOUT CENTERLINE.
- 5) RUN-OFF PART. BLEND OUT EDGE LONGITUDINALLY, TRANSITION SHOULD BE SMOOTH.
- 6) BEND PROGRESSIVELY WITH A MINIMUM OF 8 PASSES. MAXIMUM TUBE FLATTENING DUE TO BENDING IS 6% BASED ON O.D.
- 7) LIQUID PENETRANT INSPECT OUTSIDE SURFACE OF CROSSTUBE PER QSI 038.
- 8) SCRIBE DART PART NUMBER AND BATCH NUMBER IN THIS AREA WITH VIBRATING STYLUS.
- 9) INSTALL D2856-400-773 ABRASION STRIP WITH A 0.13 (REF) GAP ON BOTTOM SIDE OF CROSSTUBE, CENTERED OPPOSITE D2892-1 SUPPORT, PER QSI 035.
- 10) EXTREME CARE MUST BE TAKEN TO PROTECT THE OUTSIDE SURFACE OF THE TUBE. THE OUTSIDE SURFACE MUST BE SMOOTH AND FREE FROM SURFACE DEFECTS SUCH AS SCRATCHES, NICKS, OR DENTS. DEFECTS UP TO 0.005" MAY BE BLENDED OUT LONGITUDINALLY. CIRCUMFERENTIAL GRIND MARKS ARE UNACCEPTABLE.
- 11) IT IS OPTIONAL TO SEAL EDGES OF SUPPORTS AND ABRASION STRIP USING SIKAFLEX-241/291 SEALANT.
- 12) TORQUE CLAMPS 80 TO 100 IN-LB.

SHOP COPY
RETURN TO
ENGINEERING
UNCONTROLLED COPY
SUBJECT TO AMENDMENT
WITHOUT NOTICE
WORK ORDER
NO. 35042

Copyright © 2000 by DART AEROSPACE LTD

THIS DOCUMENT IS PRIVATE AND CONFIDENTIAL AND IS SUPPLIED ON THE EXPRESS CONDITION THAT IT IS NOT TO BE USED FOR ANY PURPOSE OR COPIED OR COMMUNICATED TO ANY OTHER PERSON WITHOUT WRITTEN PERMISSION FROM DART AEROSPACE LTD.

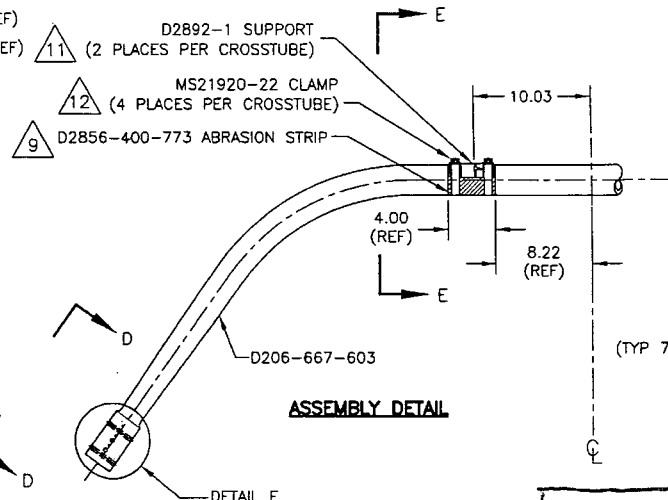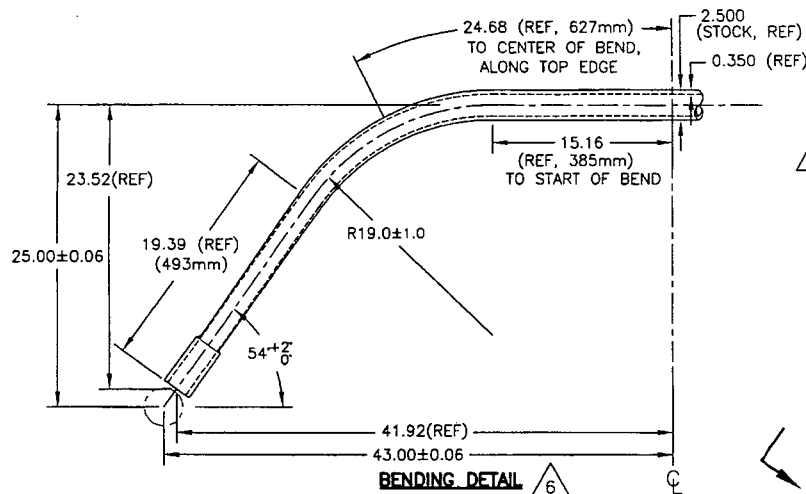

B $\phi 0.323^{+0.005}_{-0.000}$
(TYP 5 PLACES PER CUFF)
HOLE TO BE ALIGNED WITHIN ± 0.001 OF HOLE ON OTHER SIDE OF CUFF




PILOT $\phi 0.128$
C'SINK $\phi 0.225 \times 1.00$
(TYP 7 PLACES PER CUFF)

FWD SIDE ONLY

DETAIL F
SCALE 2:5

UNDER REVIEW
OK 0.2.26 PH
2-Draw detail F

FWD SIDE ONLY

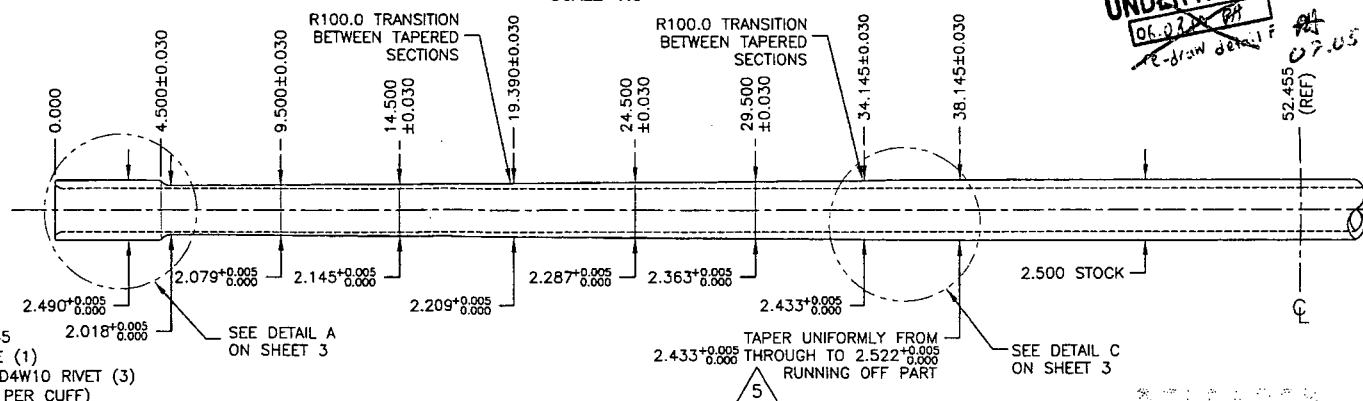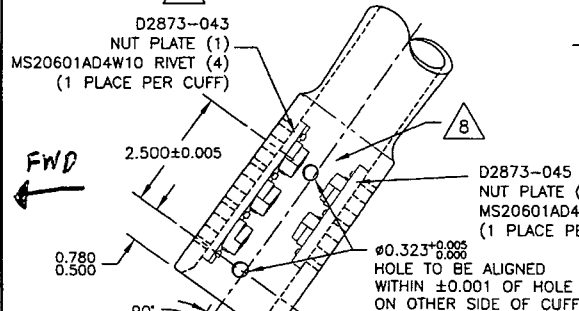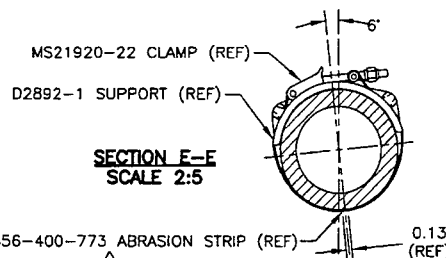


COPYRIGHT © 2000 BY DART AEROSPACE LTD.

THIS DOCUMENT IS PRIVATE AND CONFIDENTIAL AND IS SUPPLIED ON THE EXPRESS CONDITION THAT IT IS NOT TO BE USED FOR ANY PURPOSE OR COPIED OR COMMUNICATED TO ANY OTHER PERSON WITHOUT WRITTEN PERMISSION FROM DART AEROSPACE LTD.

DESIGN PH	DRAWN BY PH	DART	DART AEROSPACE LTD. HAWKESBURY, ONTARIO, CANADA
CHECKED # DS	APPROVED # DS	DRAWING NO. D206-667-243	REV. B SHEET 2 OF 3
DATE 05.07.26		TITLE CROSSTUBE ASS'Y (206L HIGH AFT)	SCALE 1:10

SHOP COPY
RETURN TO
ENGINEERING
UNCONTROLLED COPY
SUBJECT TO ATTENDMENT
WITHOUT NOTICE
WORK ORDER
35042

RELEASED
05-07-26

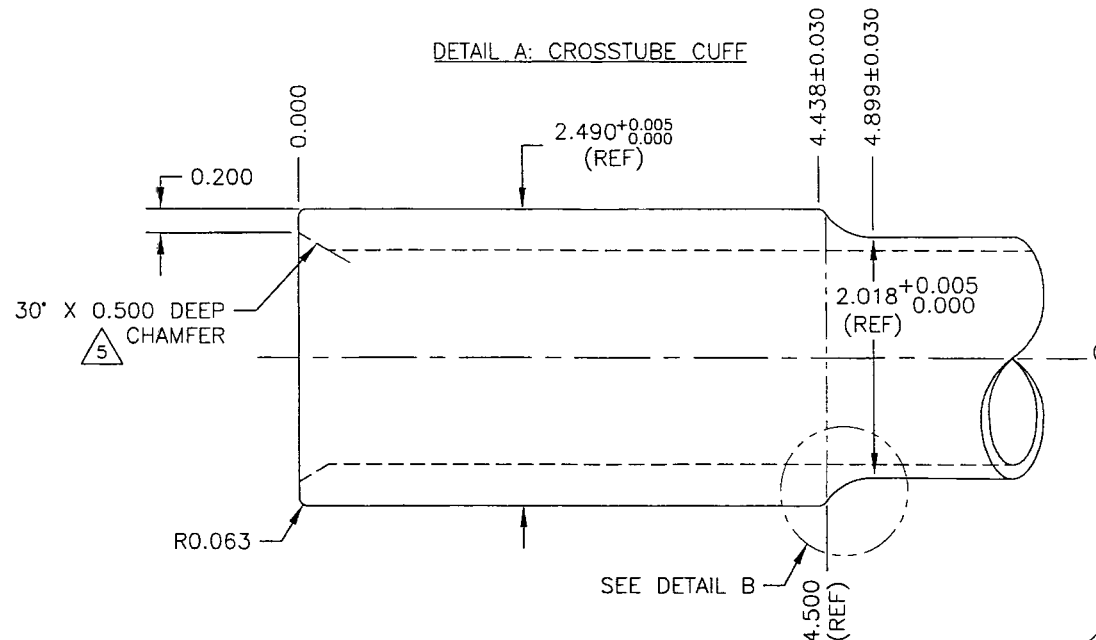


05.07.26 *ff*

UNDER REVIEW

~~06.03.05 PH~~


Re-draw detail F

R# 07.05.02

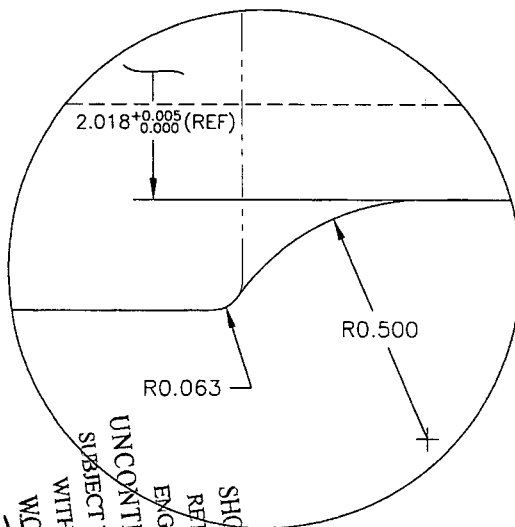

DETAIL B: CUFF
TRANSITION
SCALE 4:1

DETAIL C:
TAPER RUN-OFF
NOT TO SCALE

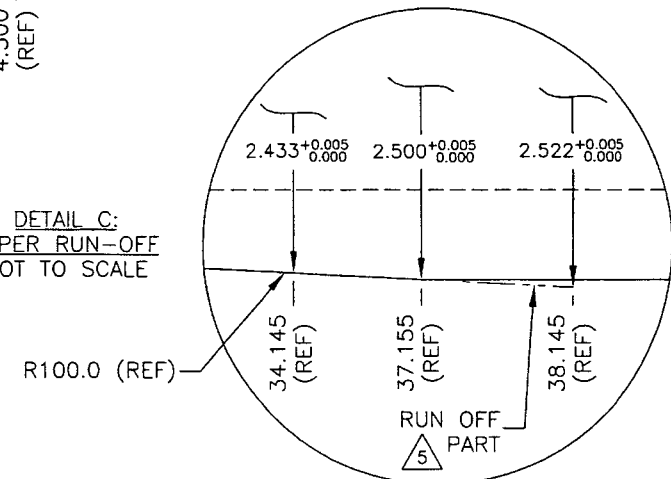

NO. 35042

WORK ORDER

UNCONTROLLED COPY

SUBJECT TO AMENDMENT

WITHOUT NOTICE

ENGINEERING

RETURN TO

SHOP COPY

COPYRIGHT © 2000 BY DART AEROSPACE LTD.		DESIGN	PH	DRAWN BY	PH	DART DART AEROSPACE LTD. NAWESBURY, ONTARIO, CANADA	REV. B
THIS DOCUMENT IS PRIVATE AND CONFIDENTIAL AND IS SUPPLIED ON THE EXPRESS CONDITION THAT IT IS NOT TO BE USED FOR ANY PURPOSE OR COPIED OR COMMUNICATED TO ANY OTHER PERSON WITHOUT WRITTEN PERMISSION FROM DART AEROSPACE LTD.		CHECKED	PH	APPROVED	PH		SHEET 3 OF 3
		DATE	05.07.26	DRAWING NO.		D206-667-243	SCALE
				TITLE		CROSSTUBE ASS'Y (206L HIGH AFT)	1:1



LIQUID PENETRANT TEST REPORT

P- 09855

CLIENT Dart Aerospace DATE Nov 2-2007 PAGE 1 OF 1
ATTENTION Linda Lucello ACUREN JOB NO. 188-07-01131 TIME AM ☒ PM ☐
ADDRESS 1270 Aberdeen St PO/VO NO. _____
Hawkesbury ON WORK LOCATION DART AEROSPACE HAWKESBURY
ACCEPTANCE STD. AS11417/CS1038 REV./DATE _____
PROJECT Fluorescent L.P.I. on FWD & AFT X-TUBES
ITEM(S) EXAMINED 206L AFT X-TUBE (X4) + 206L FWD X-TUBE (X3)
JOB #1-35041+35042+35043+35044 ~ JOB #4 34924+34925+34927

JOB DESCRIPTION _____ PROCEDURE NO. LT-XXXX REV./DATE _____ TECHNIQUE NO. LT-XXXX-XXX REV./DATE _____
PART NO. AFT-D2066672039 FWD-D206667103 MATERIAL Alclad Aluminum THICKNESS _____
SCOPE Liquid Penetrant Inspection - Fluorescent

TEST DETAILS

METHOD <input checked="" type="checkbox"/> FLUORESCENT <input type="checkbox"/> VISIBLE	<input checked="" type="checkbox"/> WATER WASH <input type="checkbox"/> SOLVENT REMOVABLE <input type="checkbox"/> POST EMULSIFIED
FAMILY BRAND <u>Magnaflux</u>	BLACK LIGHT S/N <u>8168</u> OUTPUT > 1000 μ W/CM ² <input type="checkbox"/> AMBIENT < 2 fc
PENETRANT <u>ZL-67</u> MINIMUM DWELL TIME <u>10-45 MIN.</u>	LIGHTING EQUIP. <input type="checkbox"/> FLASHLIGHT <input type="checkbox"/> TROUBLELIGHT <input type="checkbox"/> OUTPUT > 100 fc @ SURFACE
PENETRANT REMOVER <u>H2O</u> MINIMUM DRY TIME <u>> 10 MIN.</u>	OTHER <u>Cal due date - Apr 17-2008</u>
DEVELOPER MINIMUM DWELL TIME <u>10 MIN.</u>	LIGHT METER S/N _____ CAL DUE DATE _____
DEVELOPER TYPE <input type="checkbox"/> NON AQUEOUS <input type="checkbox"/> AQUEOUS <input type="checkbox"/> DRY	

TEST SURFACE

SURFACE CONDITION ☐ AS GROUND ☐ AS WELDED ☐ MACHINED ☐ SHOT BLASTED ☐ CLEAN BARE METAL
SURFACE TEMPERATURE ☐ < -4°C/ 20°F ☐ -4°C/ 20°F TO 10°C/ 50°F ☐ 10°C/ 50°F TO 52°C/ 125°F ☐ > 52°C/ 125°F

RESULTS- (☐ METRIC ☐ IMPERIAL)

ITEM	COMMENTS	ACCEPT	REJECT
	Inspection was completed on 100% of external surfaces. Several linear indications were re-worked & removed. No further indications were found after re-inspection.		
	JOB #1 34927 & 34924 of FWD X-TUBES had a linear indication that was re-worked & inspected @ a later date.		
	JOB # 35043 AFT X-TUBE had a linear indication. This part failed after re-work & re-inspection & will be re-worked & inspected @ a later date.		

Scope of Services
The agreement of Acuren Group Inc. to perform services extends only to those services provided for in writing. Under no circumstances shall such services extend beyond the performance of the requested services. It is expressly understood that all descriptions, comments and expressions of opinion reflect the opinions or observations of Acuren Group Inc. based on information and assumptions supplied by the owner/operator and are not intended nor can they be construed as representations or warranties. Acuren Group Inc. is not assuming any responsibilities of the owner/operator and the owner/operator retains complete responsibility for the engineering, manufacture, repair and use decisions as a result of the data or other information provided by Acuren Group Inc. In no event shall Acuren Group Inc.'s liability in respect of the services referred to herein exceed the amount paid for such services.

Standard of Care
In performing the services provided, Acuren Group Inc. uses the degree, care and skill ordinarily exercised under similar circumstances by others performing such services in the same or similar locality. No other warranty, expressed or implied, is made or intended by Acuren Group Inc.

SIGNATURES

CLIENT REPRESENTATIVE <u>Pat Lucello</u> SIGNATURE _____ DTR # <u>27471</u>	
TECHNICIAN (SIGNATURE): <u>Pat Lucello</u> SIGNATURE _____	REPORT REVIEWED BY: _____
NAME (PRINT): <u>PAT LUCELLO</u> 1 ST TECHNICIAN	NAME _____ INITIALS _____
CGSB LEVEL <u>II</u> SNT LEVEL <u>II</u> CGSB REG. NO. <u>3387</u>	2 ND TECHNICIAN
CGSB LEVEL _____ SNT LEVEL _____ CGSB REG. NO. _____	